

South Carolina Department of Health and Environmental Control
Office of Ocean and Coastal Resource Management
104 Parker Drive
Beaufort, South Carolina 29906

August 7, 2013
Permit Application Public Notice

James Edward Byrd, OCRM-13-202-W

The Department has received an application for a permit for the alteration of a critical area. The application was submitted pursuant to the Coastal Zone Management Act (Act 123) of 1977 South Carolina General Assembly. The application in brief, is described as follows:

LOCATION: On and adjacent to May River at 47 Windy Knoll Lane, Bluffton, Beaufort County, South Carolina.
TMS: R600 037 000 019A 0000.

WORK: The work as proposed consists of constructing an addition to a dock. Specifically, the applicant seeks to add a 12' x 13', four-pile boatlift ebbtide of the pierhead. The work as described is for private, recreational use.

This public notice is being distributed to all known interested persons and agencies to assist in developing facts on which a decision by the Department can be based. Comments concerning the proposed work must be submitted in writing, setting forth sufficient detail to furnish a clear understanding of the reasons for support or opposition.

Comments regarding this application must be received by the Department on or before **August 22, 2013**. For more information, please contact **Paul Wojoski** at **843-846-9400** or via email at **wojoskpa@dhec.sc.gov**.


NOTE: Plans depicting the proposed work are available and will be provided upon receipt of a written request or may be viewed on the Department website at **www.scdhec.gov/environment/ocrm/public_notice.htm**.



GASQUE & ASSOCIATES INC.
LAND SURVEYORS & PLANNERS

28 PROFESSIONAL VILLAGE CIRCLE, BEAUFORT, S.C.
P.O. BOX 1363, BEAUFORT, S.C.
PHONE (843) 522-1798

SHEET # 1 OF 3

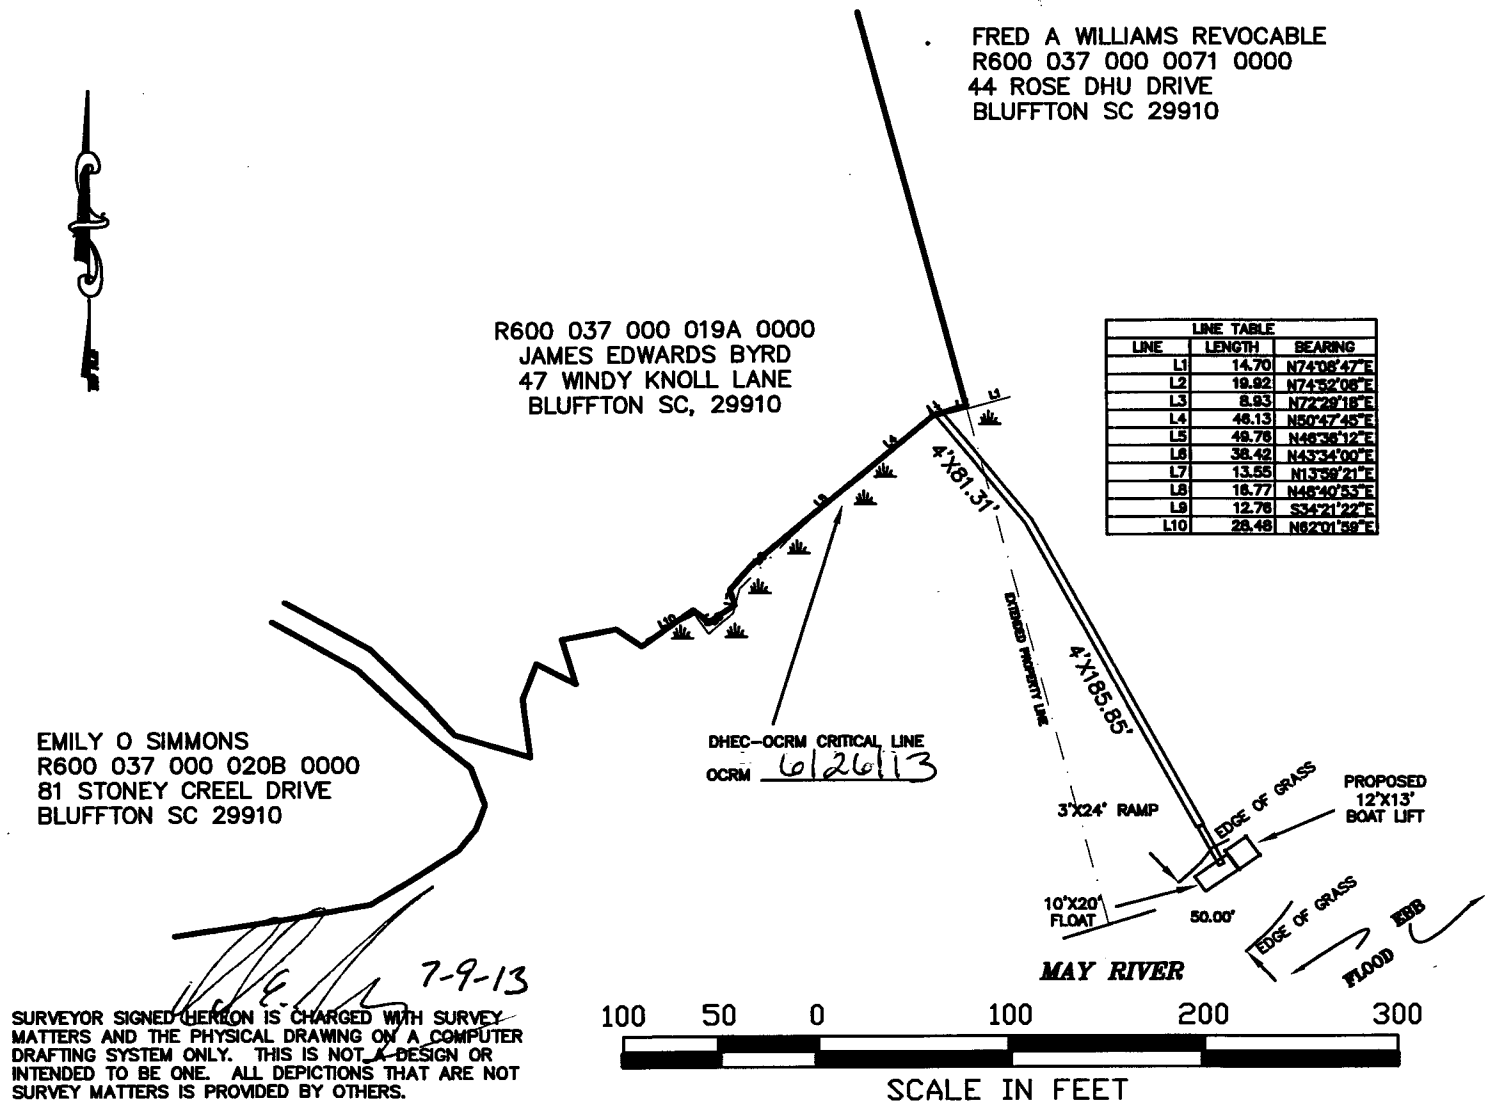

ADJACENT PROPERTY OWNERS:

- FRED A WILLIAMS REVOCABLE**
R600 037 000 0071 0000
44 ROSE DHU DRIVE
BLUFFTON SC 29910
- EMILY O SIMMONS**
R600 037 000 020B 0000
81 STONEY CREEL DRIVE
BLUFFTON SC 29910

OCRM-13-202-W

SCALE: 1"=100'

R600 037 000 019A 0000
JAMES EDWARDS BYRD
47 WINDY KNOLL LANE
BLUFFTON SC, 29910

DOCK ASBUILT SURVEY

IN: MAY RIVER
AT: BLUFFTON TOWNSHIP

COUNTY OF: BEAUFORT
STATE: SOUTH CAROLINA

JOB# 40420 DSGN 7

DATE: 6/17/2013




GASQUE & ASSOCIATES INC. **LAND SURVEYORS & PLANNERS**

28 PROFESSIONAL VILLAGE CIRCLE, BEAUFORT, S.C.
P.O. BOX 1363, BEAUFORT, S.C.
PHONE (843) 522-1798

PLAN VIEW

SHEET # 2 OF 3


NOT TO SCALE

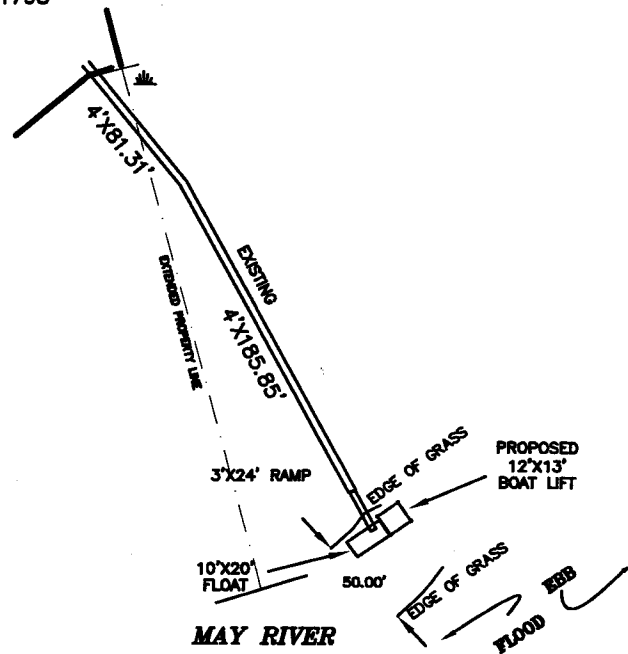

MAY RIVER

NOT TO SCALE

PROFILE VIEW

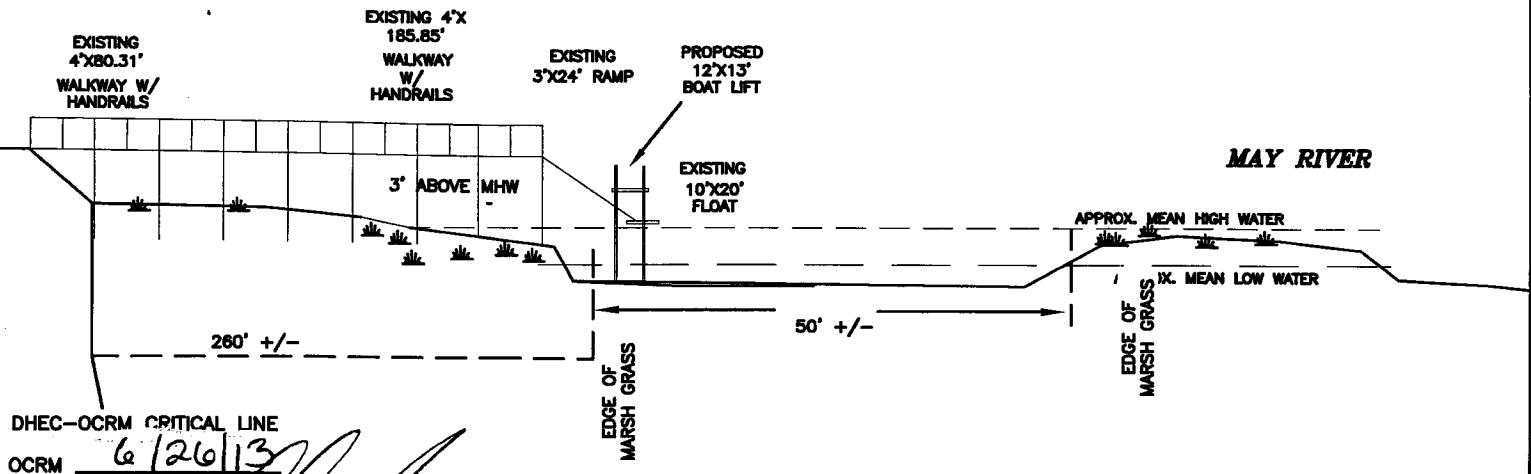

SURVEYOR SIGNED HEREON IS CHARGED WITH SURVEY MATTERS AND THE PHYSICAL DRAWING ON A COMPUTER DRAFTING SYSTEM ONLY. THIS IS NOT A DESIGN OR INTENDED TO BE ONE. ALL DEPICTIONS THAT ARE NOT SURVEY MATTERS IS PROVIDED BY OTHERS.

ADJACENT PROPERTY OWNERS:

- FRED A WILLIAMS REVOCABLE
R600 037 000 0071 0000
44 ROSE DHU DRIVE
BLUFFTON SC 29910
- EMILY O SIMMONS
R600 037 000 020B 0000
81 STONEY CREEL DRIVE
BLUFFTON SC 29910

R600 037 000 019A 0000
JAMES EDWARDS BYRD
47 WINDY KNOLL LANE
BLUFFTON SC, 29910

DOCK ASBUILT SURVEY

IN: MAY RIVER
AT: BLUFFTON TOWNSHIP

COUNTY OF: BEAUFORT
STATE: SOUTH CAROLINA

JOB# 40420 DSGN 7

DATE: 6/17/2013



Trip to:












47 Windy Knoll Ln

Bluffton, SC 29910-6802

29.94 miles / 42 minutes

Notes

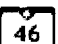A 104 Parker Dr, Beaufort, SC 29906-8315


-  1. Start out going **east** on **Parker Dr** toward **Hilanda Dr**. [Map](#)
0.7 Mi
0.7 Mi Total
-   2. Take the 3rd **right** onto **Trask Pky / US-21 S**. [Map](#)
Trask Pky is 0.1 miles past Theatre Dr
If you are on Trask Pky and reach Poppy Hill Rd you've gone about 0.3 miles too far
3.0 Mi
3.7 Mi Total
-   3. Turn **right** onto **SC-280 / Parris Island Gtwy**. [Map](#)
SC-280 is 0.7 miles past Salt Creek Dr W
If you are on US-21 and reach Walsh Dr you've gone about 0.1 miles too far
1.2 Mi
4.9 Mi Total
-   4. Turn **slight right** onto **Robert Smalls Pky / SC-170 S**. [Map](#)
SC-170 S is 0.2 miles past Ambrose Run
If you are on Parris Island Gtwy and reach Old Jericho Rd you've gone about 0.3 miles too far
22.0 Mi
26.9 Mi Total
-   5. Enter next roundabout and take the 3rd exit onto **SC-46 / May River Rd**. [Map](#)
2.8 Mi
29.7 Mi Total
-  6. Turn **right** onto **Windy Knoll Ln** (Gate access required). [Map](#)
If you reach Rose Dhu Dr you've gone about 0.1 miles too far
0.2 Mi
29.9 Mi Total
-  7. **47 WINDY KNOLL LN** is on the **left**. [Map](#)
Your destination is at the end of Windy Knoll Ln

B 47 Windy Knoll Ln, Bluffton, SC 29910-6802

OCRM-13-202-W

Total Travel Estimate: 29.94 miles - about 42 minutes

BOOK TRAVEL with **mapquest** (877) 577-5766

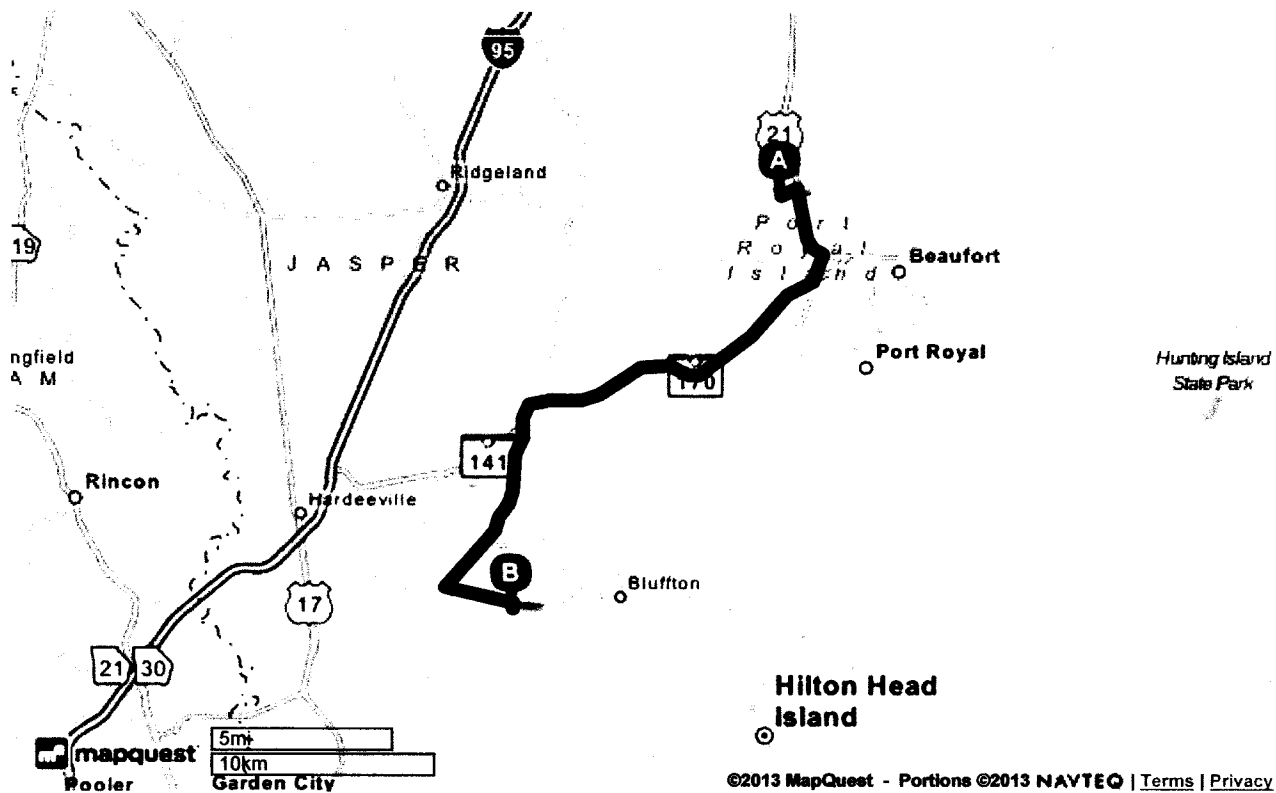

©2013 MapQuest, Inc. Use of directions and maps is subject to the MapQuest Terms of Use. We make no guarantee of the accuracy of their content, road conditions or route usability. You assume all risk of use. [View Terms of Use](#)

OCRM-13-202-W

RECEIVED

JUL 25 2013

DHEC-OCRM

CHARLES R. OFFICE

<http://www.mapquest.com/print?a=app.core.ace205ece5013020ec8595a6>